





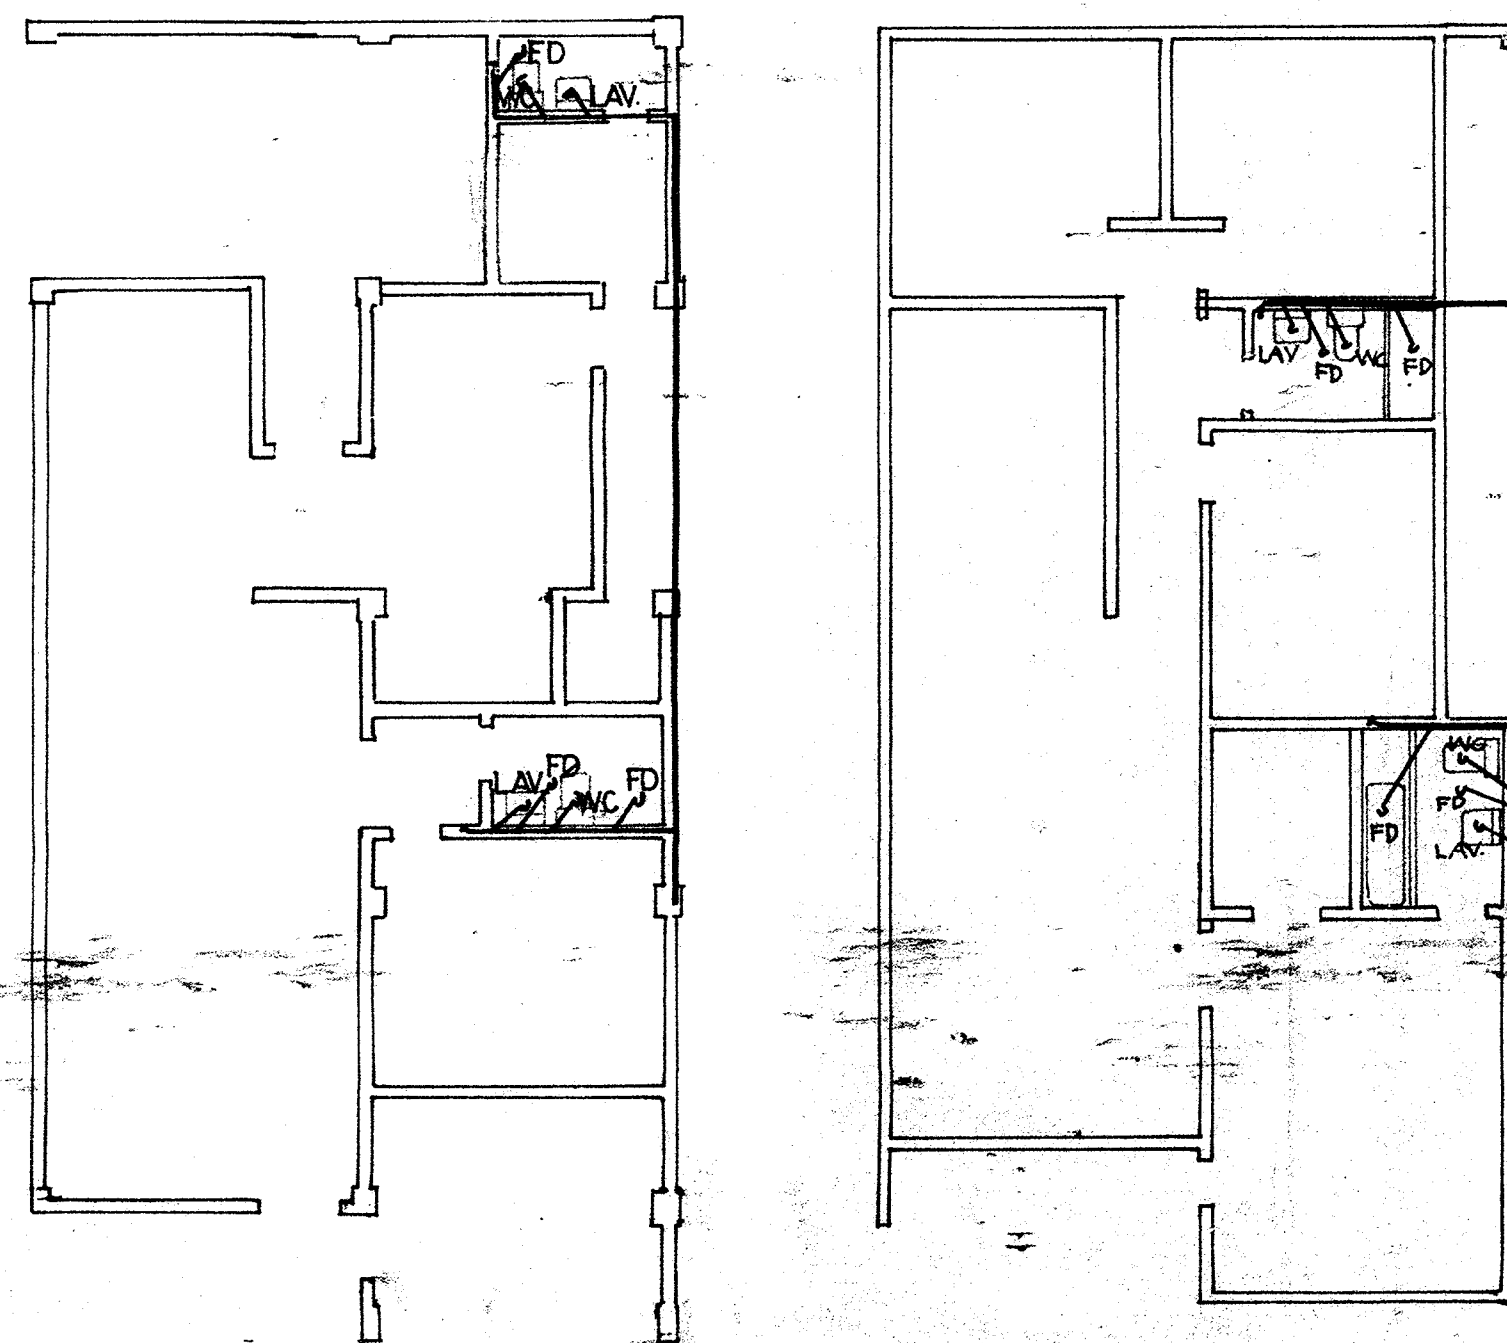


GROUND & 2ND FLOOR PLUMBING LAYOUT


LEGEND :					
	W.C	WATER CLOSET		WATER METER	
	LAV	LAVATORY		CHECK VALVE	
	K.S	KITCHEN SINK		GATE VALVE	
	C.O	CLEAN OUT		75 MM PVC PIPE CLEAN WATER SUPPLY	
	F.D	FLOOR DRAIN		100 MM PVC WATER PIPE	
	VSTR	VENT STOCK THRU ROOF		150 MM CONC DRAIN PIPE	
	C.B	CATCH BASIN		SHOWER HEAD WITH VALVE	

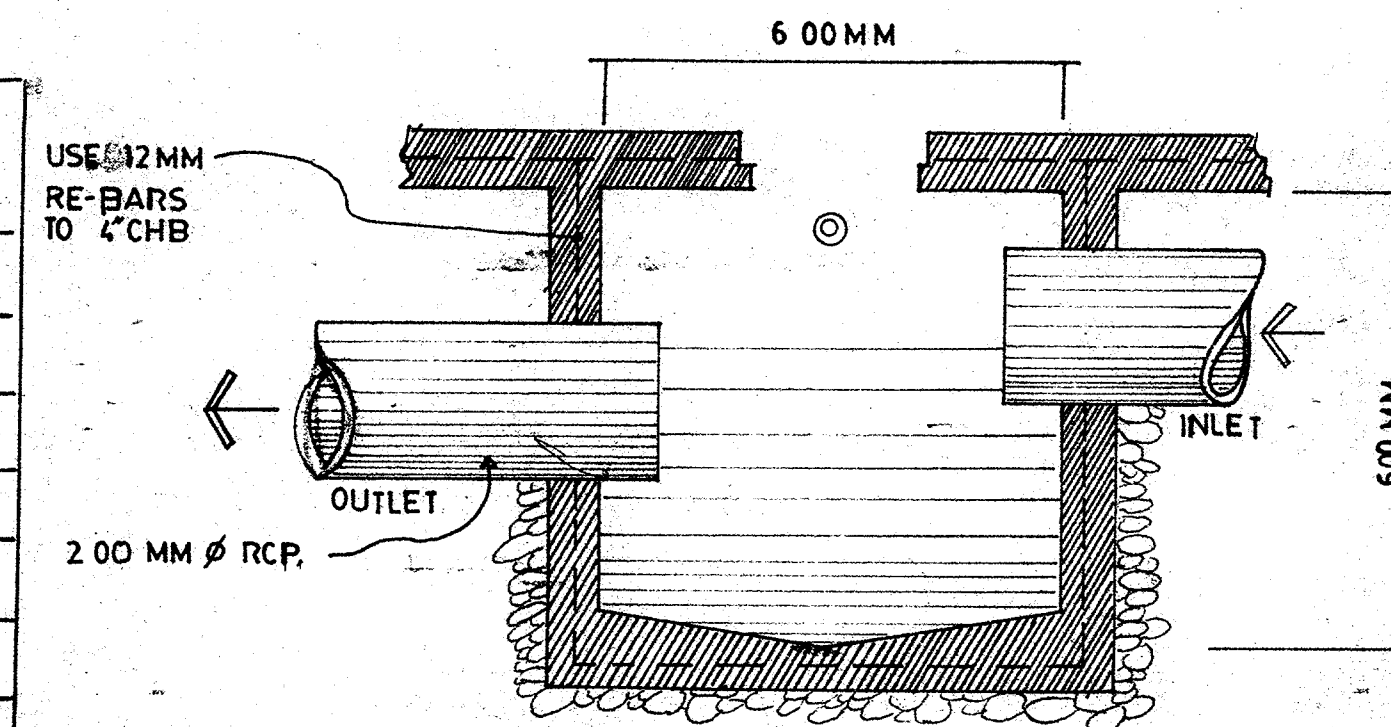

DETAIL SECTION

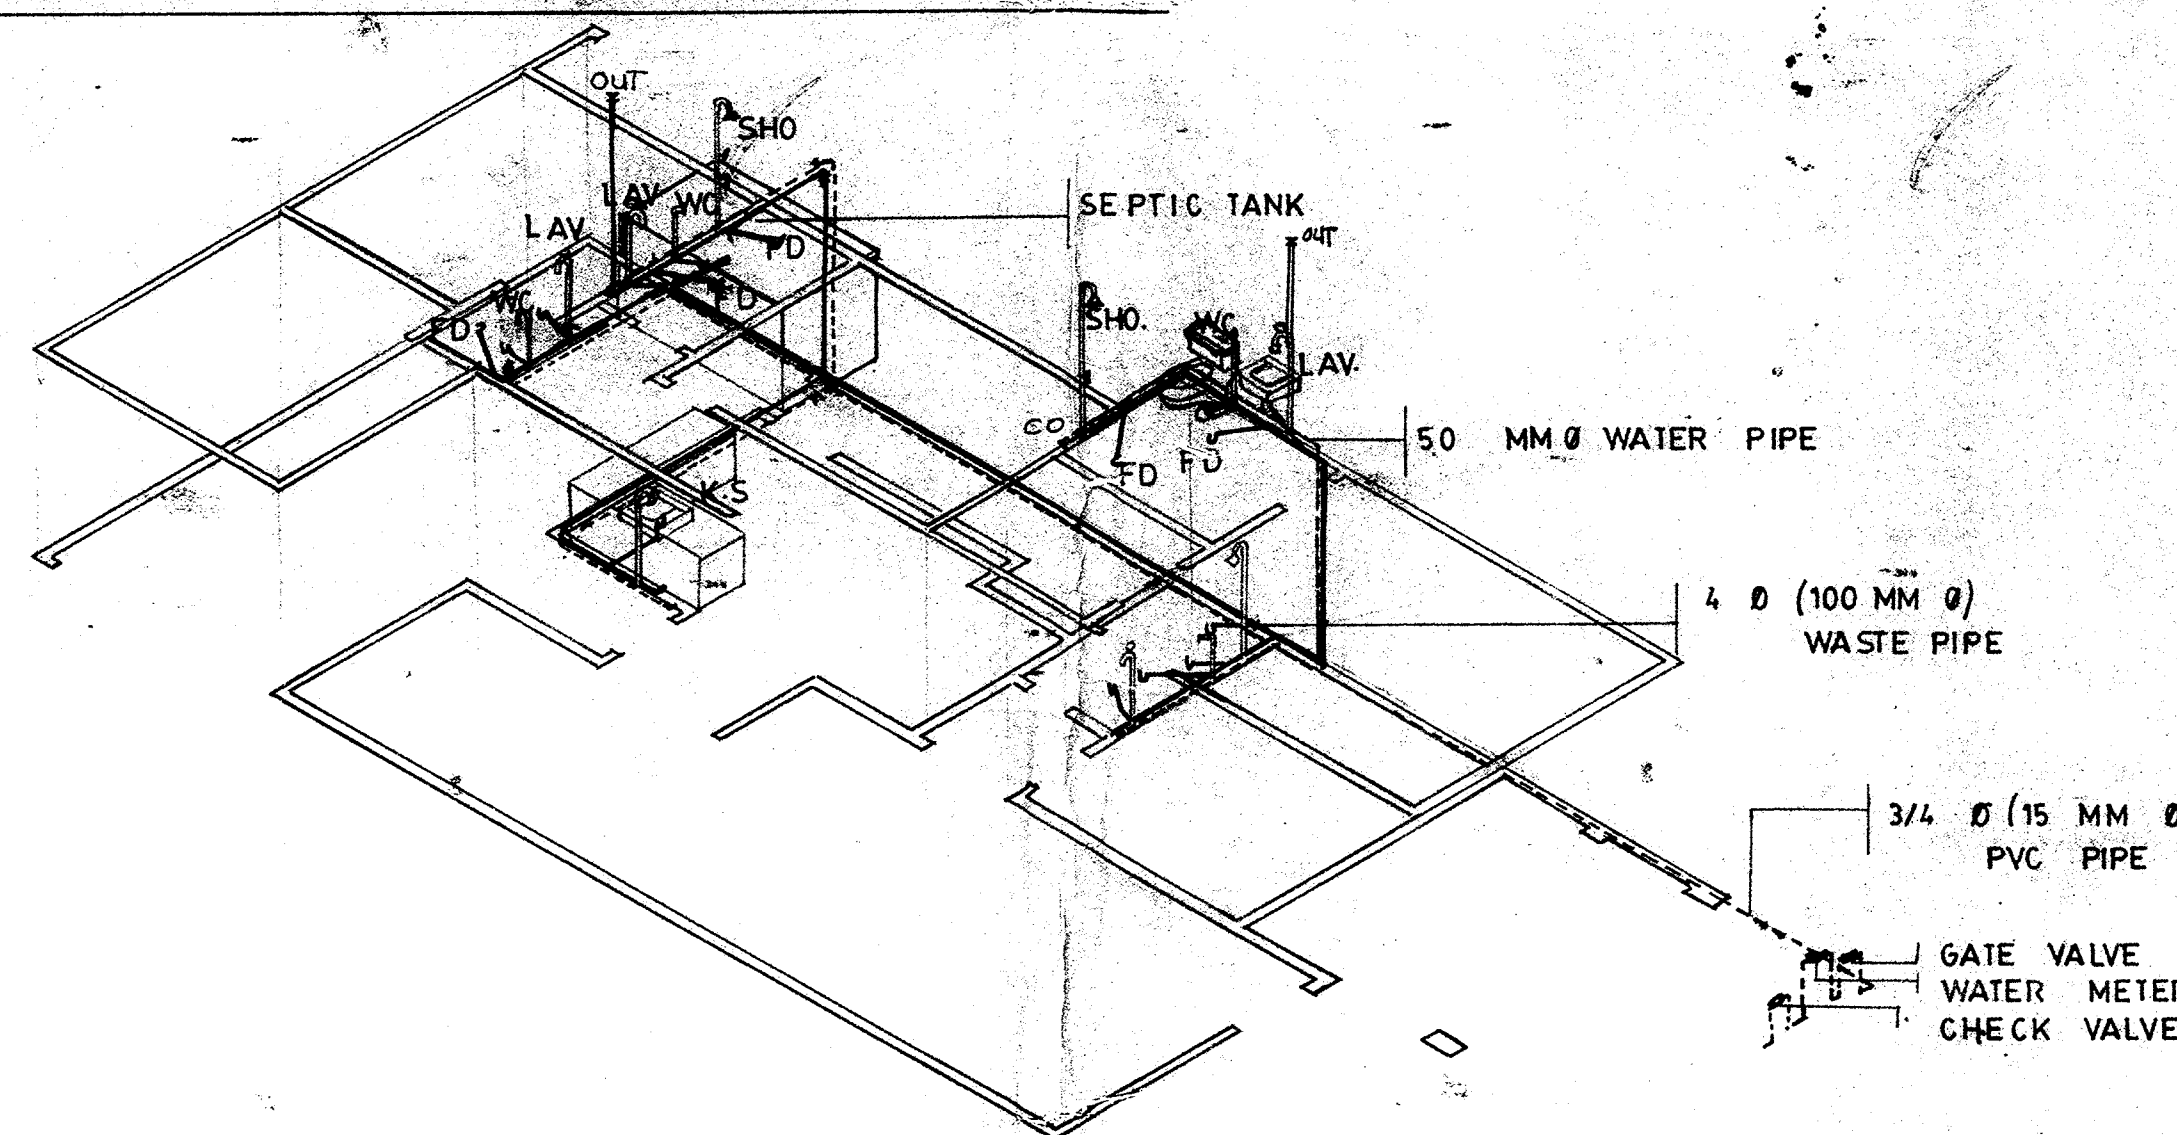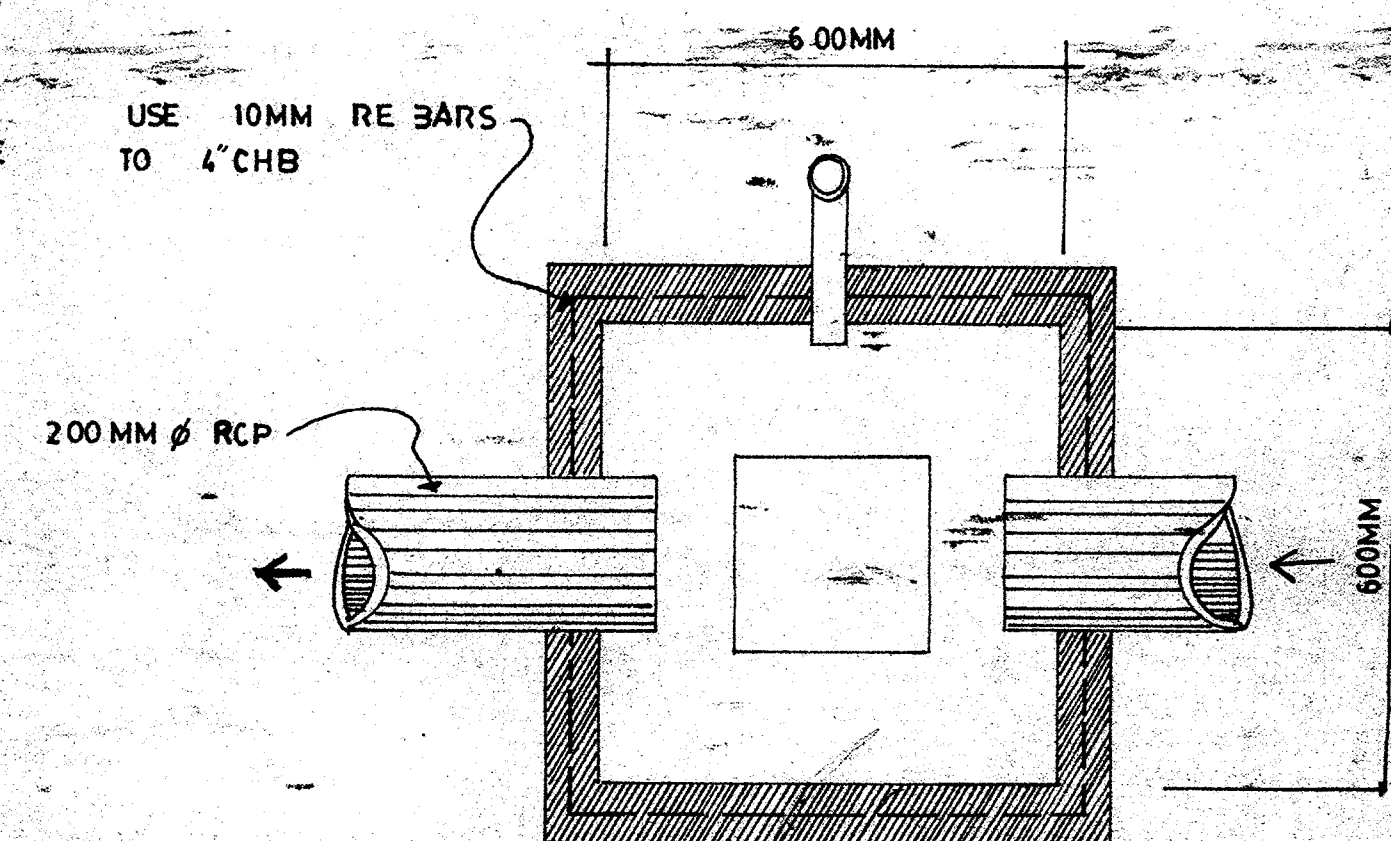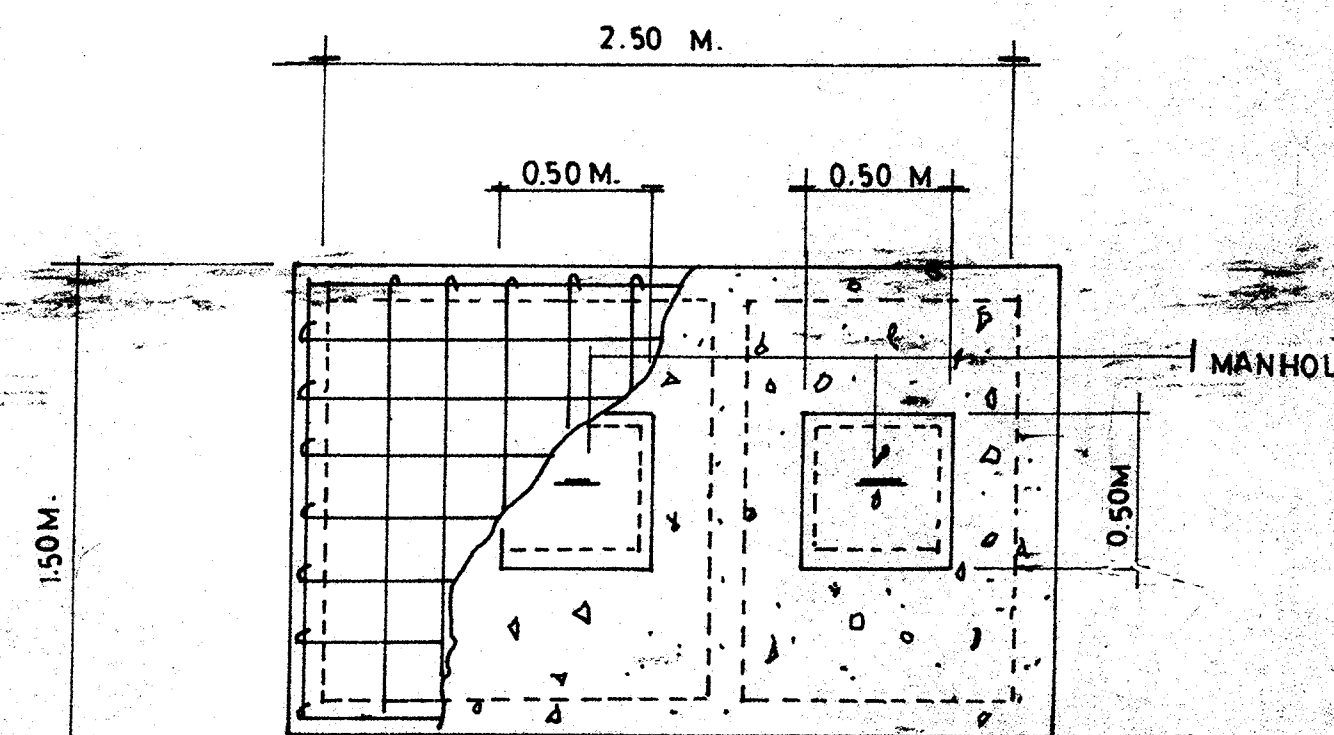

ISOMETRIC DIAGRAM OF PLUMBING

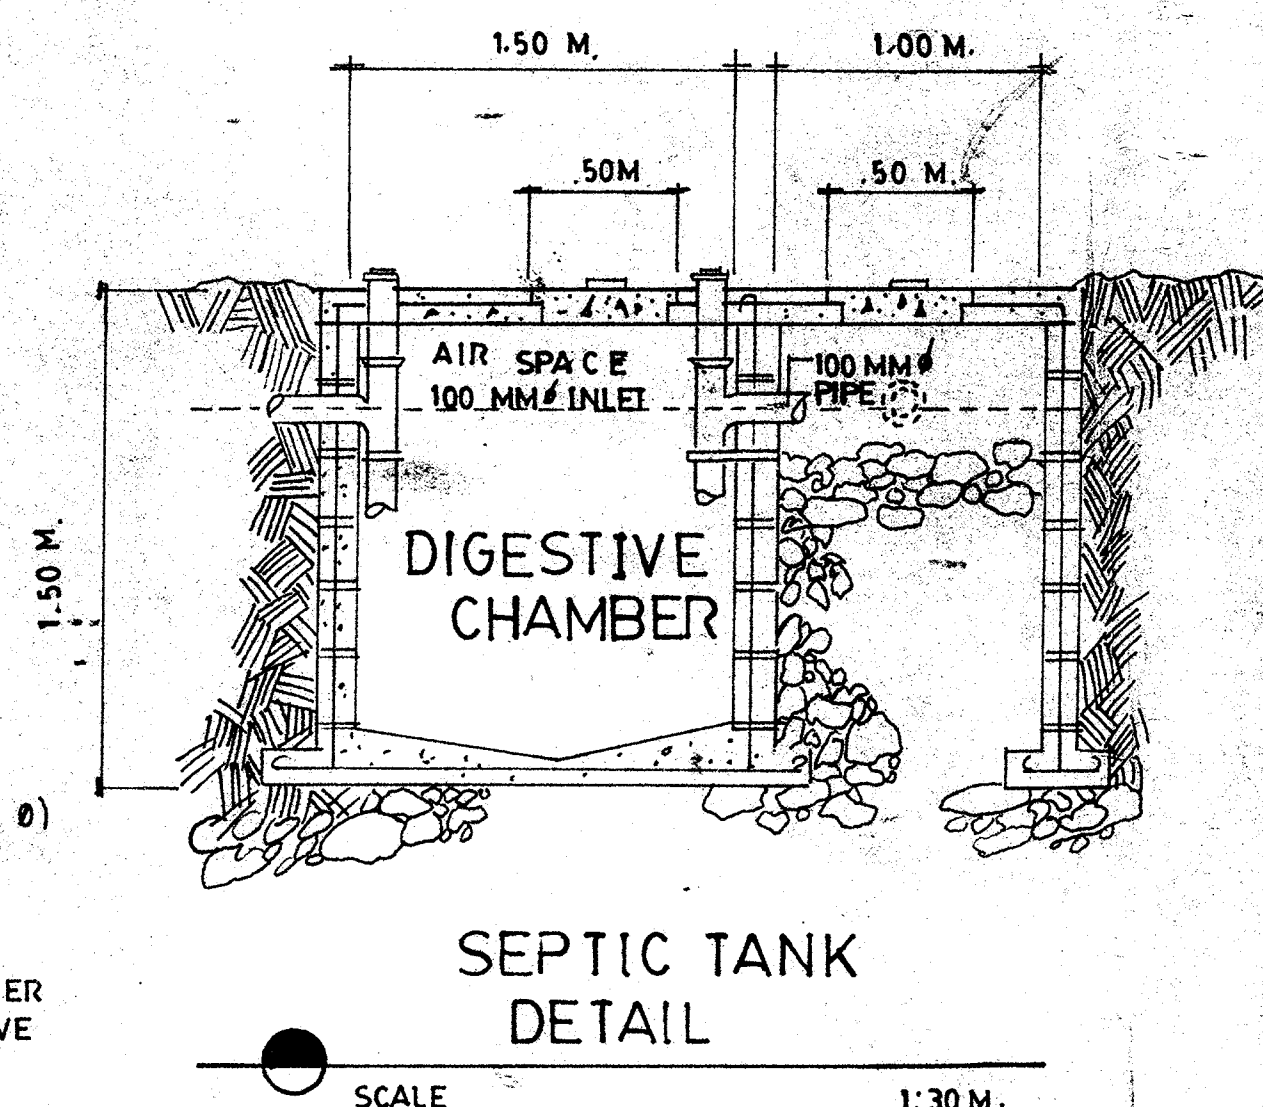

SEPTIC TANK DETAIL

CATCH BASIN DETAIL

SPECIFICATIONS:

1. ALL PLUMBING WORKS MUST BE DONE IN ACCORDANCE WITH THE PROVISIONS OF THE PHIL. PLUMBING CODE AND WITH THE LATEST RULES AND REGULATIONS OF THE LOCAL SANITARY AGENCY.
2. ALL MATERIALS TO BE USED SHALL BE NEW AND APPROVED TYPE FOR LOCATION AND PURPOSES. USE PVC PIPES NELTEX BRAND OR APPROVED EQUIVALENT FOR SANITARY WASTE SYSTEM THICKNESS MUST BE SCHEDULE 40.
3. SEPTIC VAULT MUST BE WATER TIGHT COMPLETE WITH NECESSARY REQUIREMENTS OF A TYPICAL APPROVED OR VAULT.
4. ALL WORKS MUST BE OF CLASS WORKMANSHIP PIPINGS SYSTEM MUST BE DOUBLE CHECKED ESPECIALLY ON JOINTS TO INSURE WATERTIGHT PLUMBING SYSTEM.
5. ALL WORKS HEREIN SHALL BE UNDER THE DIRECT SUPERVISION OF A FULLY LICENSED MASTER PLUMBER OR SANITARY ENGR.

Designed by:	Project / Location	Certified by	PRC NO. 2078-98	Sheet content	Owner	Sheet No.
ANDREW B. SANCHEZ	PROPOSED THREE STOREY RESIDENTIAL BUILDING	ENGR. SANTIAGO BUENCONSEJO	Issued on: 1-13-98	AS SHOWN ABOVE	MR. & MRS. CLENIO CABREDO	18/18
Architectural Designer	CRUZADA LEGAZPI CITY	Master Plumber	Issued at: TABACO			